


SHORT HILLS PLAZA
636 MORRIS TPK.
SHORT HILLS, NJ 07078

SUITE 2C: OFFICE LAYOUT
1,798 SQFT
Scale: 1/8"=1'

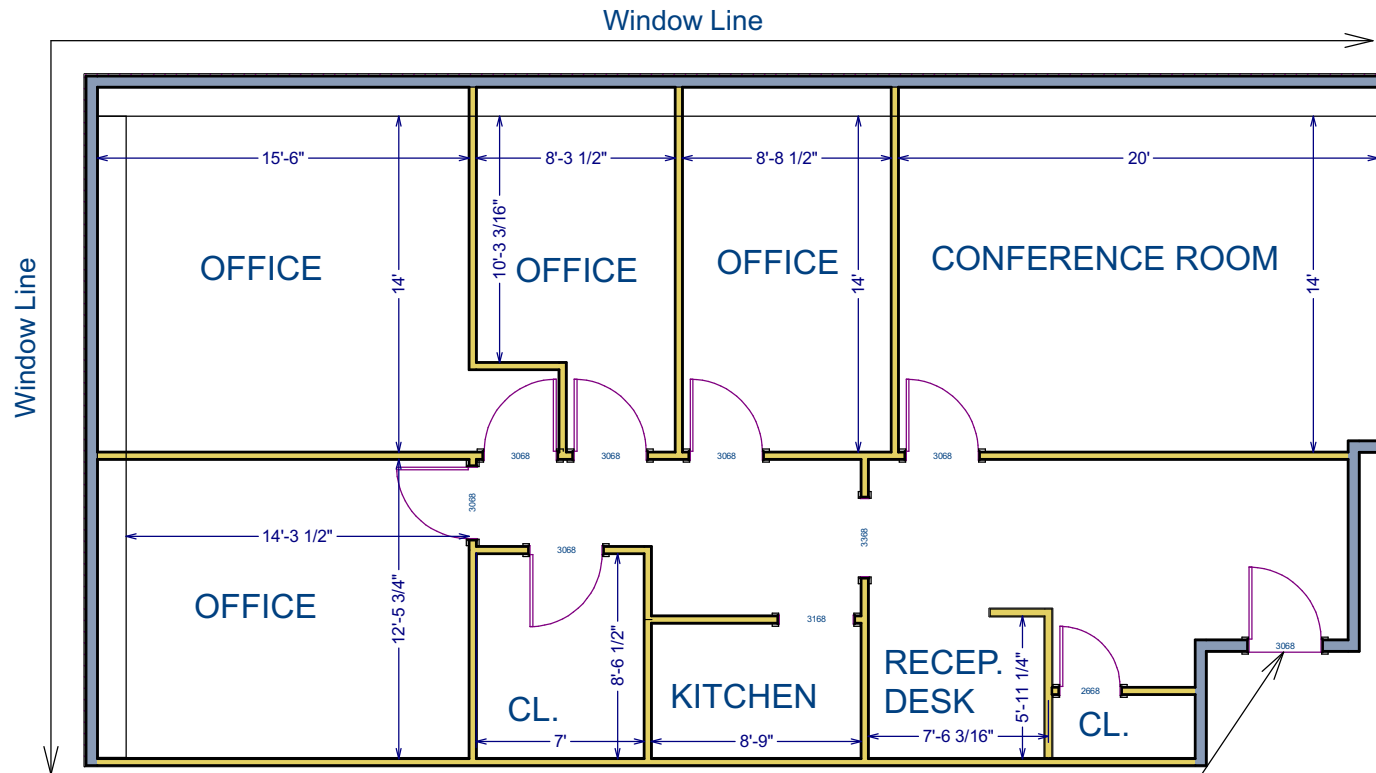

Suite Entrance

Prepared by DVP
**all dimensions are approx.